

CONTACT:
 STOBER GROUP
 #1700 - 1631 DICKSON AVENUE
 KELOWNA, B.C. V1Y 0B5
 PHONE: 250.763.2305
 FAX: 250.763.4244


NOTES:
 ALL DIMENSIONS, LAYOUTS, &
 CALCULATIONS ARE APPROXIMATE &
 MUST BE VERIFIED ON SITE PRIOR TO
 ANY CONSTRUCTION OR INSTALLATION.

LAYOUTS ARE SUBJECT TO CHANGE
 DUE TO EXISTING CONDITIONS.


CLIENT NAME:
 STOBER GROUP /
 LANDMARK DISTRICT

PROJECT ADDRESS:
 1628 DICKSON AVE. KELOWNA

JOB DESCRIPTION:
 LANDMARK 4, FLOOR 1

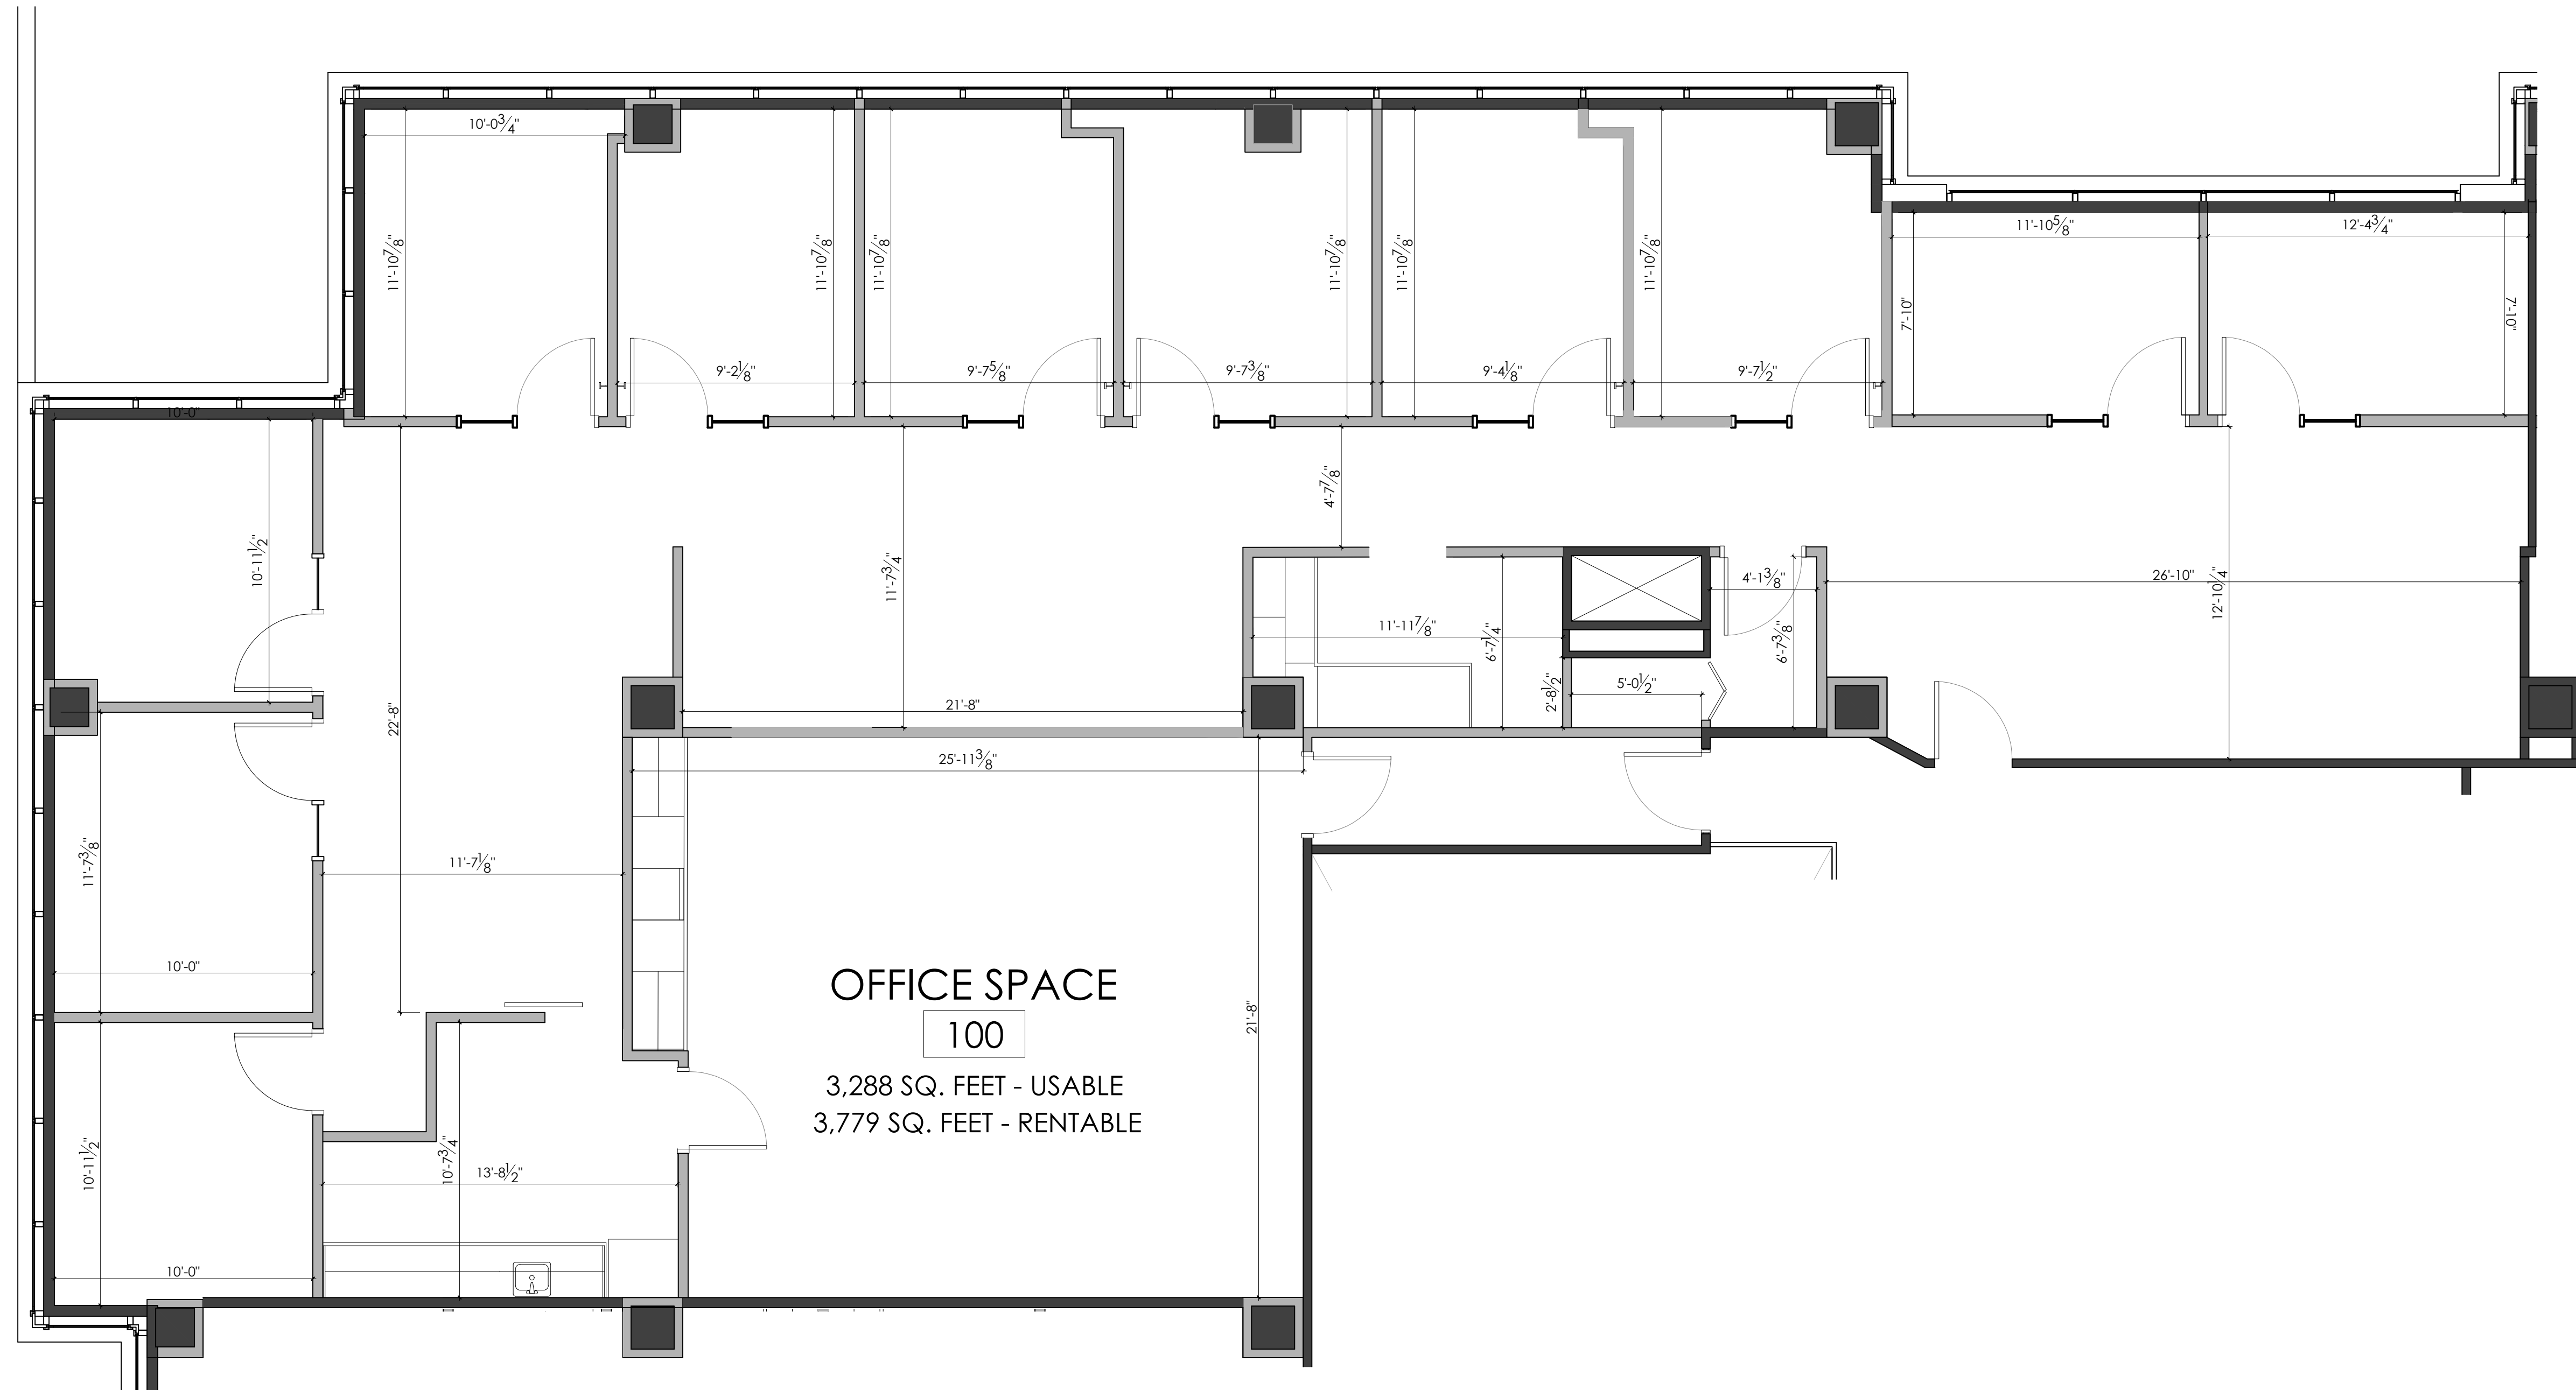

01 #100 - OFFICE SPACE - SCHEDULE A
 2.2 SCALE - 1/4" = 1'-0"

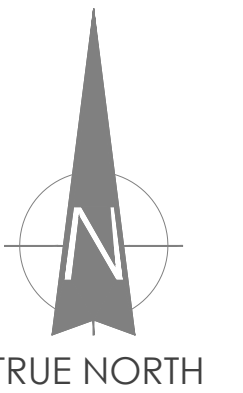

ISSUE FOR:
SCHEDULE A

REVISIONS:

No.	Description	Date	By

DRAWING TITLE:
 SCHEDULE A

SCALE:
 REFER TO DRAWING

DRAWN BY:
 CJS

CHECKED BY:

SHEET NO.
 2.2